


17249 NE 125

AS BUILT

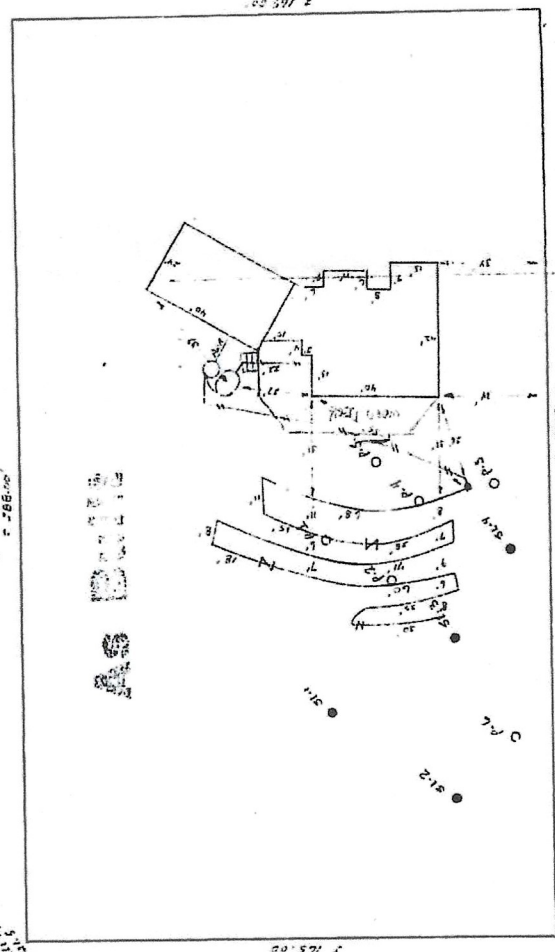

NE 126th STREET

- LEGEND
- PILE TEST
 - SOIL LOG
 - A- TIGHT LINE
 - B- STEP DOWN
 - N- DOMESTIC WATER



AS BUILT

| | |
|---|------------------|
| DRAINFIELD DESIGN FOR BOOR CONSTRUCTION INC. 4918 NW 4th ST BELLEVUE 33006 Ph. 673-2850 | |
| APPROVED BY: | DRAWN BY S. BAMA |
| SCALE: 1" = 30' | REVISED: |
| DATE: 28 JAN 83 | |
| DESIGNER: | |
| DESIGN ADDRESS: | |
| | DRAWING NUMBER |