NOTICE: IF THE DOCUMENT IN THIS FRAME IS LESS CLEAR THAN THIS NOTICE, IT IS DUE TO THE QUALITY OF THE DOCUMENT.

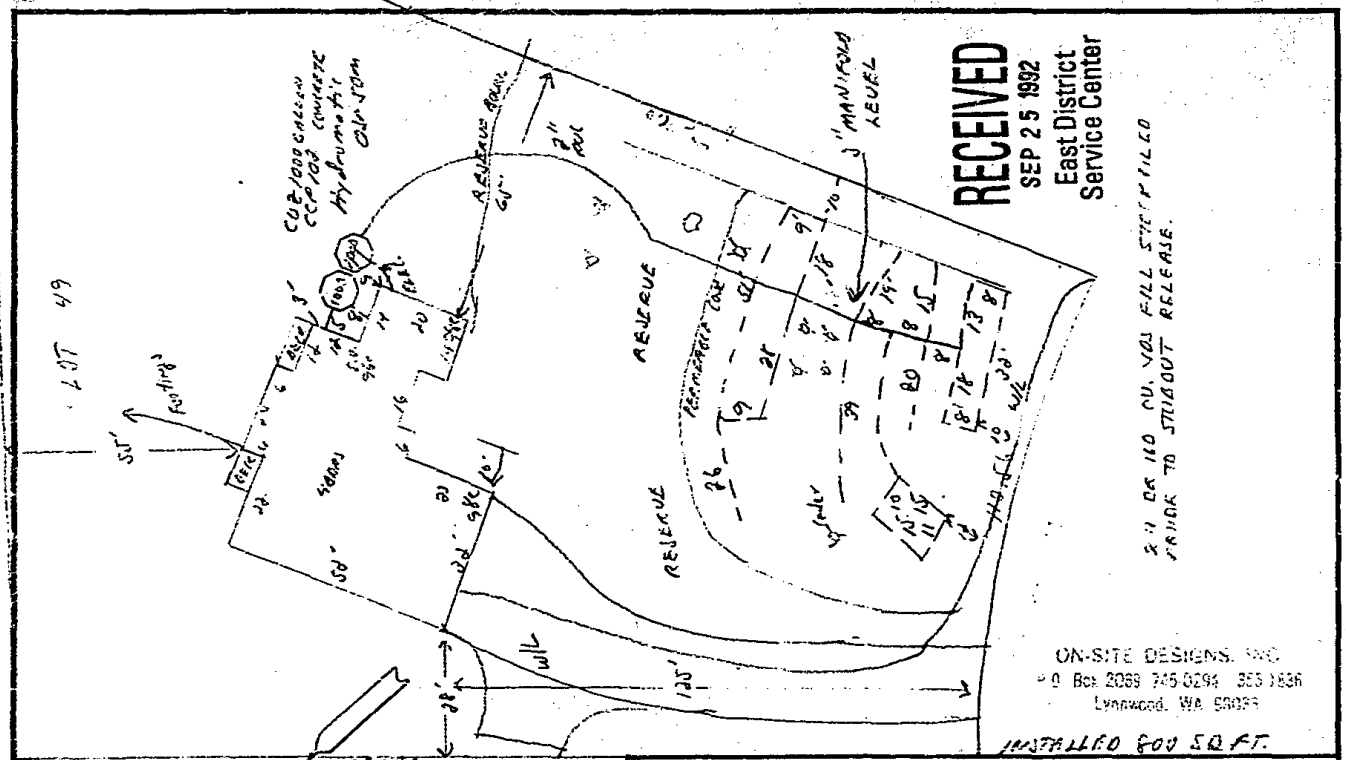


All work to conform to rules and regs of King County Health Department. No change of this design or house location without prior approval of On-Site Designs, Inc.

| | | |
|---|---|---|
| SCALE: 1"=30' | APPROVED BY: Lot 49 | DRAWN BY TL IJ |
| DATE: 9/30/90 | 19718 - 222nd Ave. NE. | REVISED 9/21/92 |

Install 1000 gallon septic tank with 400 lineal ft. of drainfield installed at a depth of min/max 9/16" into original soil.

No heavy clearing or disturbing of soil with heavy equipment before installation.

DRAWING NUMBER AS-BUILT

8½ X 11 PRINTED ON NO. 1000H CLEARPRINT ®